


SECTION - (ALPHA-1) (CONCOURSE LEVEL)

(OF ALPHA)

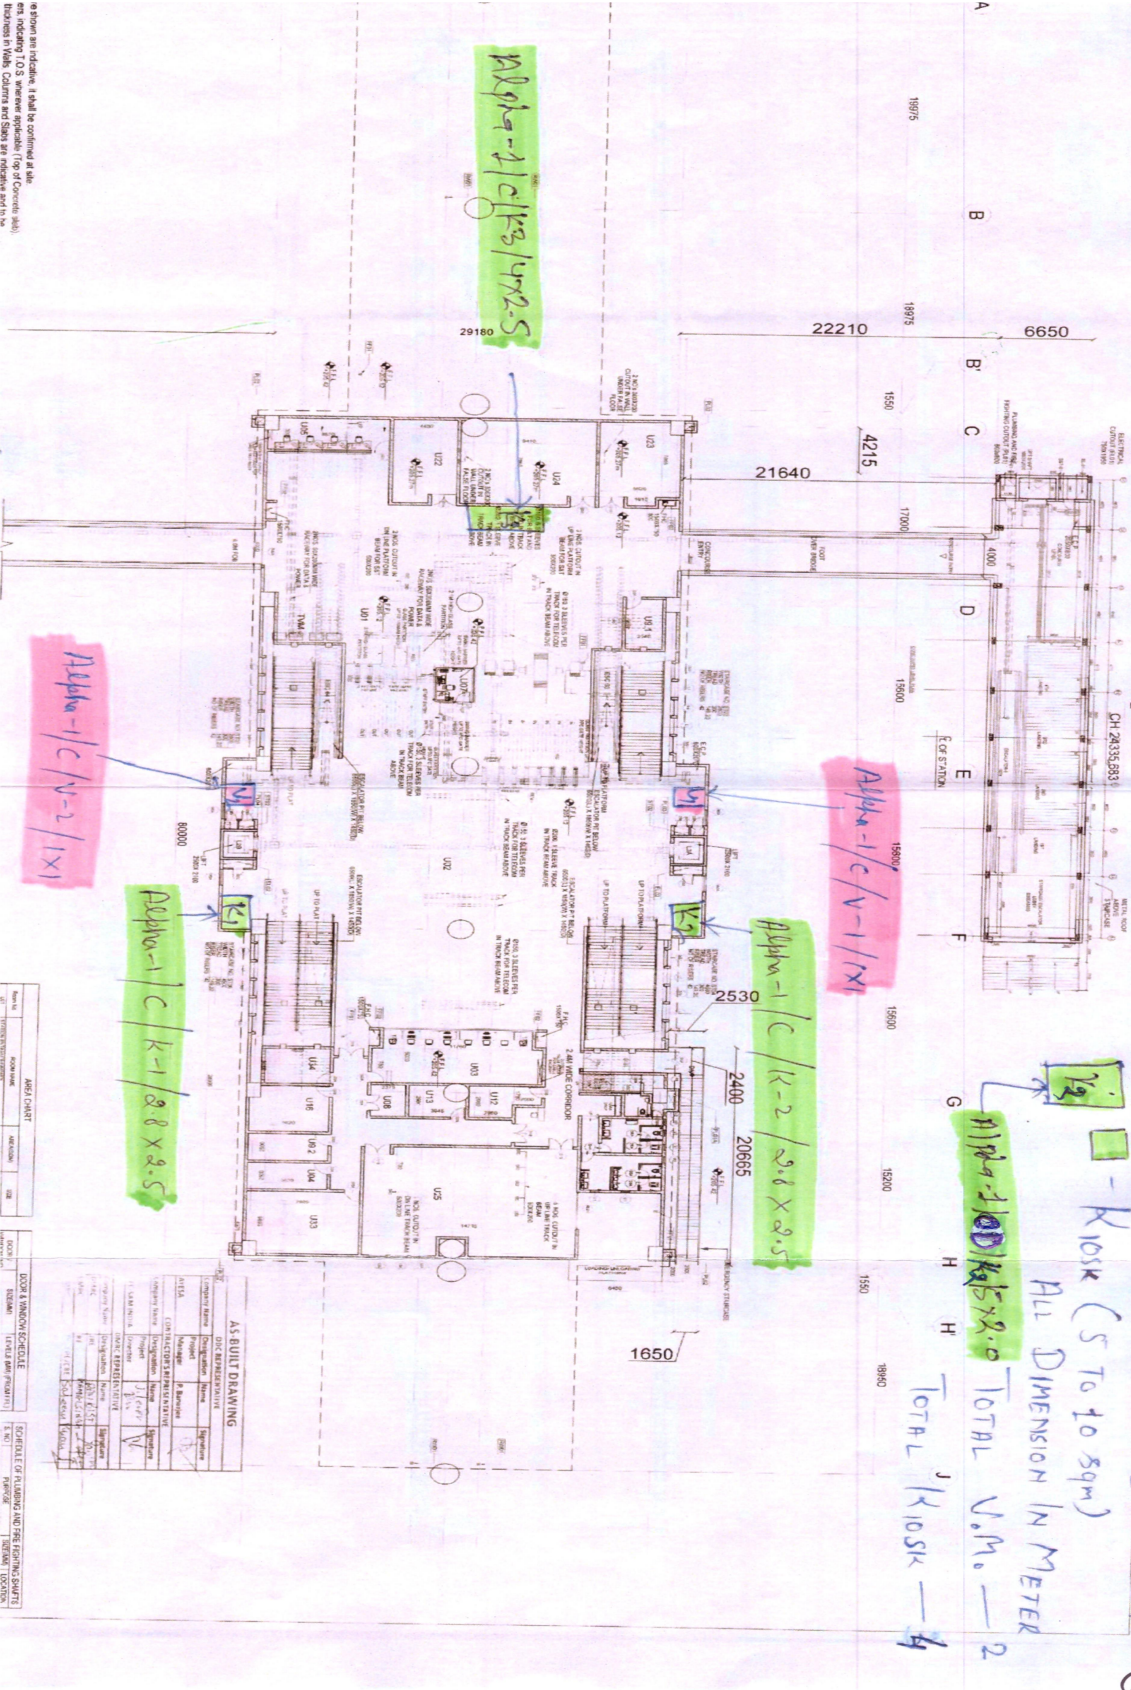

AS BUILT DRAWING

| NO. | REVISION | DATE | BY | CHKD. |
|-----|----------|------|----|-------|
| | | | | |

| NO. | REVISION | DATE | BY | CHKD. |
|-----|----------|------|----|-------|
| | | | | |

AS BUILT DRAWING

DATE: 15/10/2011

BY: [Signature]