


Sector-51  
Platform level



TOWARDS BECOT

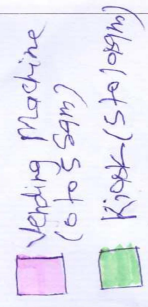

All dimensioh in meter  
Total V.M. = 1 nos  
Total Kiosk = 0

Sec-51 (P/V/10-513)

AS BUILT DRAWING		DSC REPRESENTATIVE	
Company Name	Description	Signature	Date
AVISA	AVISA	[Signature]	4
Company Name	Description	Signature	Date
CONTRACTOR	CONTRACTOR	[Signature]	
Company Name	Description	Signature	Date
CLIENT	CLIENT	[Signature]	

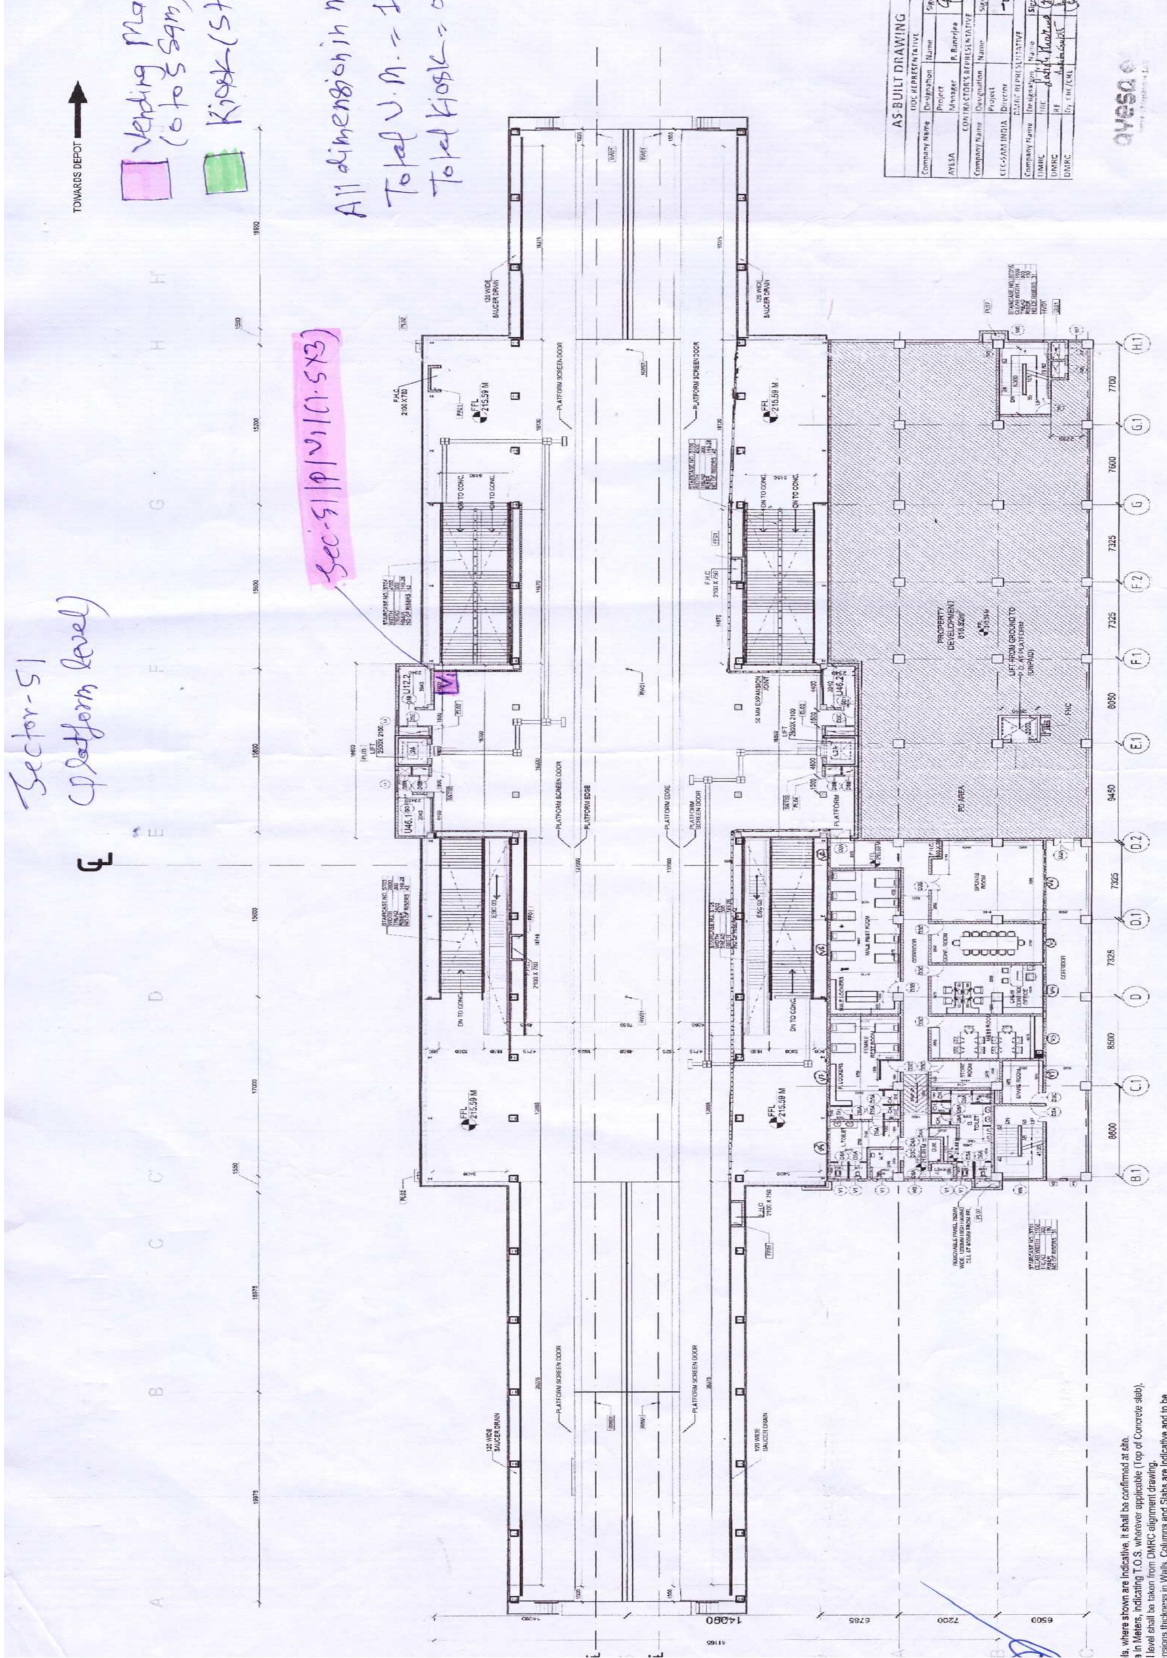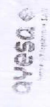

1. All dimensions are indicative. It shall be confirmed at site.  
2. In Millers, indicating T.O.S. wherever applicable (Top of Concrete slab).  
3. Level shall be taken from DMRC alignment drawing.  
4. Non-Structural Walls, Columns and Slabs are Indicated and to be