


Vending Machine  
 10.55m  
 15.75m  
 V=0  
 K=5

All dimensions in  
 mptly

Sec-137 (Ground Level)

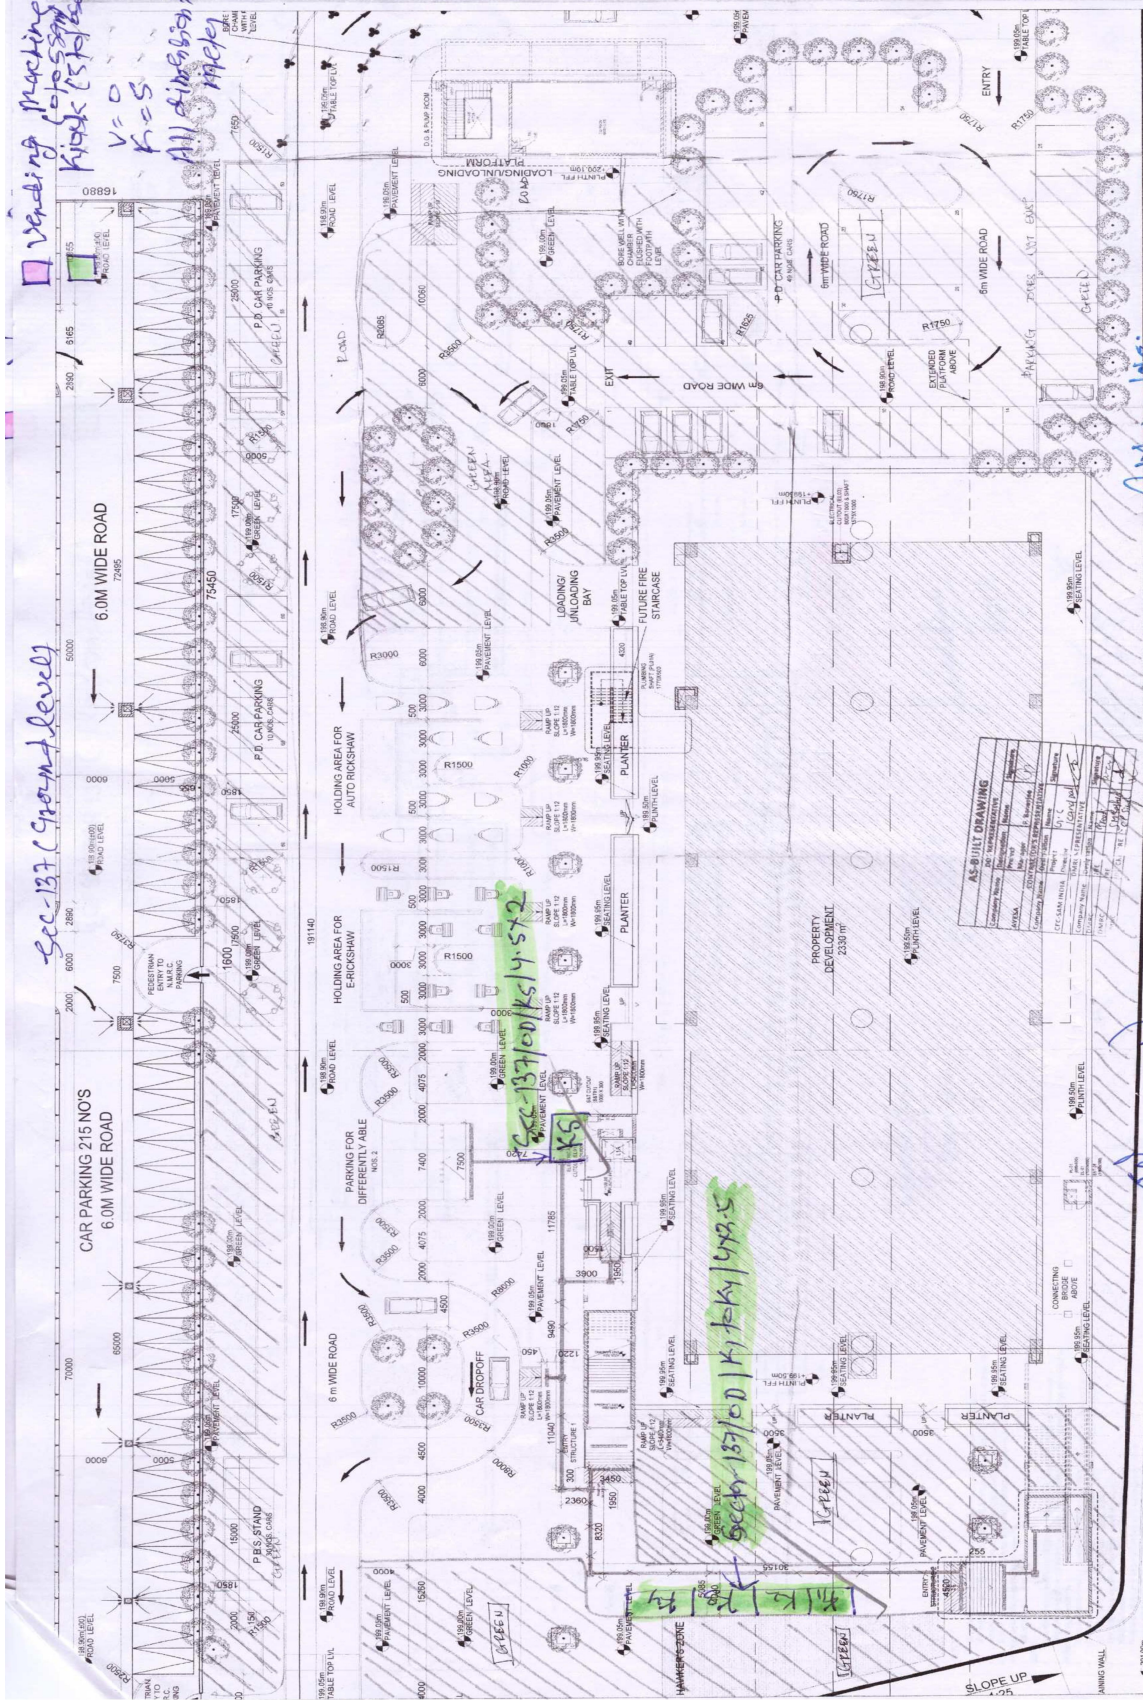

AS-BUILT DRAWING	
Scale	1:100
Author	[Signature]
Check	[Signature]
Approved	[Signature]
Date	10/11/2010
Project	Sec-137/00/KS/14.5x2
Sheet No.	1/1
Sheet Title	Sec-137/00/KS/14.5x2
Client	[Signature]
Contract No.	[Signature]
Contract Name	[Signature]
Contract Address	[Signature]
Contract Date	[Signature]
Contract Value	[Signature]
Contract Status	[Signature]
Contract Type	[Signature]
Contract Reference	[Signature]
Contract Description	[Signature]
Contract Location	[Signature]
Contract Contact	[Signature]
Contract Phone	[Signature]
Contract Email	[Signature]
Contract Website	[Signature]
Contract Fax	[Signature]
Contract FPO	[Signature]
Contract PO	[Signature]
Contract POB	[Signature]
Contract POC	[Signature]
Contract POF	[Signature]
Contract POFU	[Signature]
Contract POFI	[Signature]
Contract POFB	[Signature]
Contract POFD	[Signature]
Contract POFM	[Signature]
Contract POFN	[Signature]
Contract POFX	[Signature]
Contract POFY	[Signature]
Contract POFZ	[Signature]
Contract POF1	[Signature]
Contract POF2	[Signature]
Contract POF3	[Signature]
Contract POF4	[Signature]
Contract POF5	[Signature]
Contract POF6	[Signature]
Contract POF7	[Signature]
Contract POF8	[Signature]
Contract POF9	[Signature]
Contract POF0	[Signature]