


Sector-142 Platform level

 - Vending Machine (0 to 5 Sgm)

 - Kiosk (5 to 10 Sgm)

All Dimensions are in meter


TOWARDS
DEPOT

TOTAL V.M. - 2

TOTAL KIOSK - 0

TOWARDS
SEC. - 71

SECTOR: 142
CH. 0673.900
E OF STATION

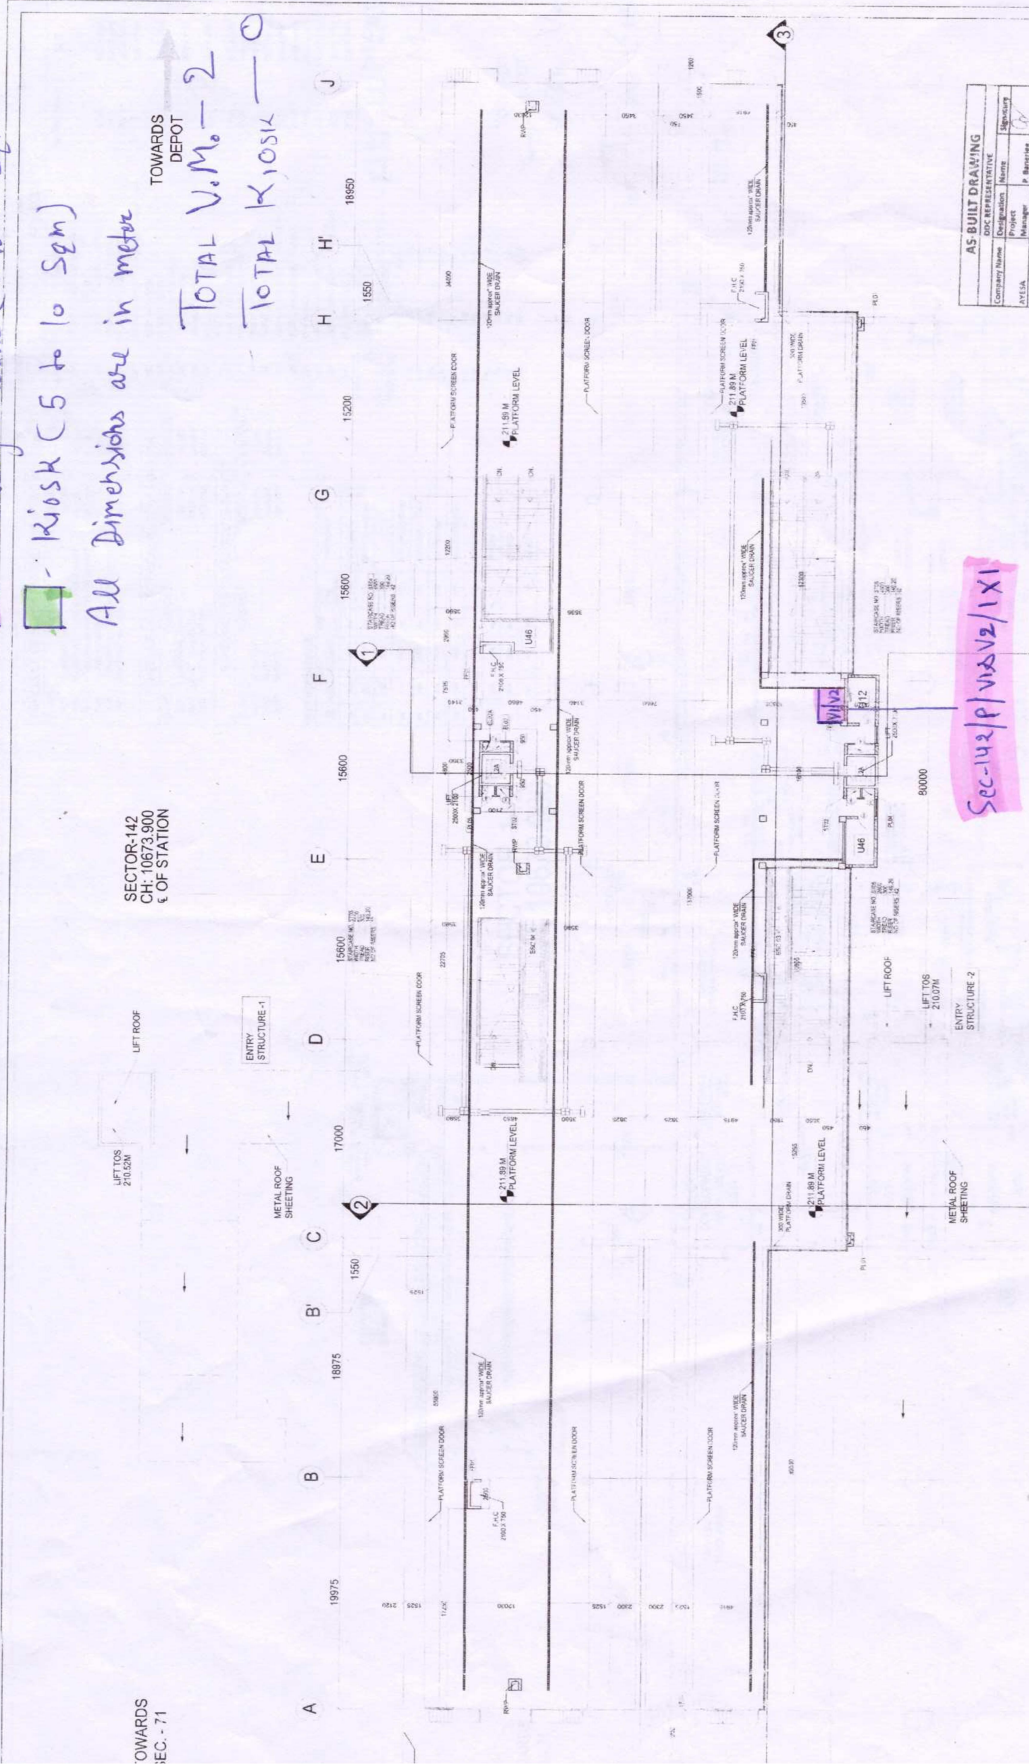

Sec-142 P / VIS V2 / XI

AS-BUILT DRAWING			
DIOC REFLECTIVE			
Company Name	Designation	Issue	Signature
ATISA	Project Manager		