SECTOR-76 (GROUND LEVEL)

- VENDING MACHINE (0 TO 5 S
- KIOSK (5 TO 10 Sqm)

ALL DIMENSION IN METER

TOTAL V.M. - 0

TOTAL KIOSK - 7

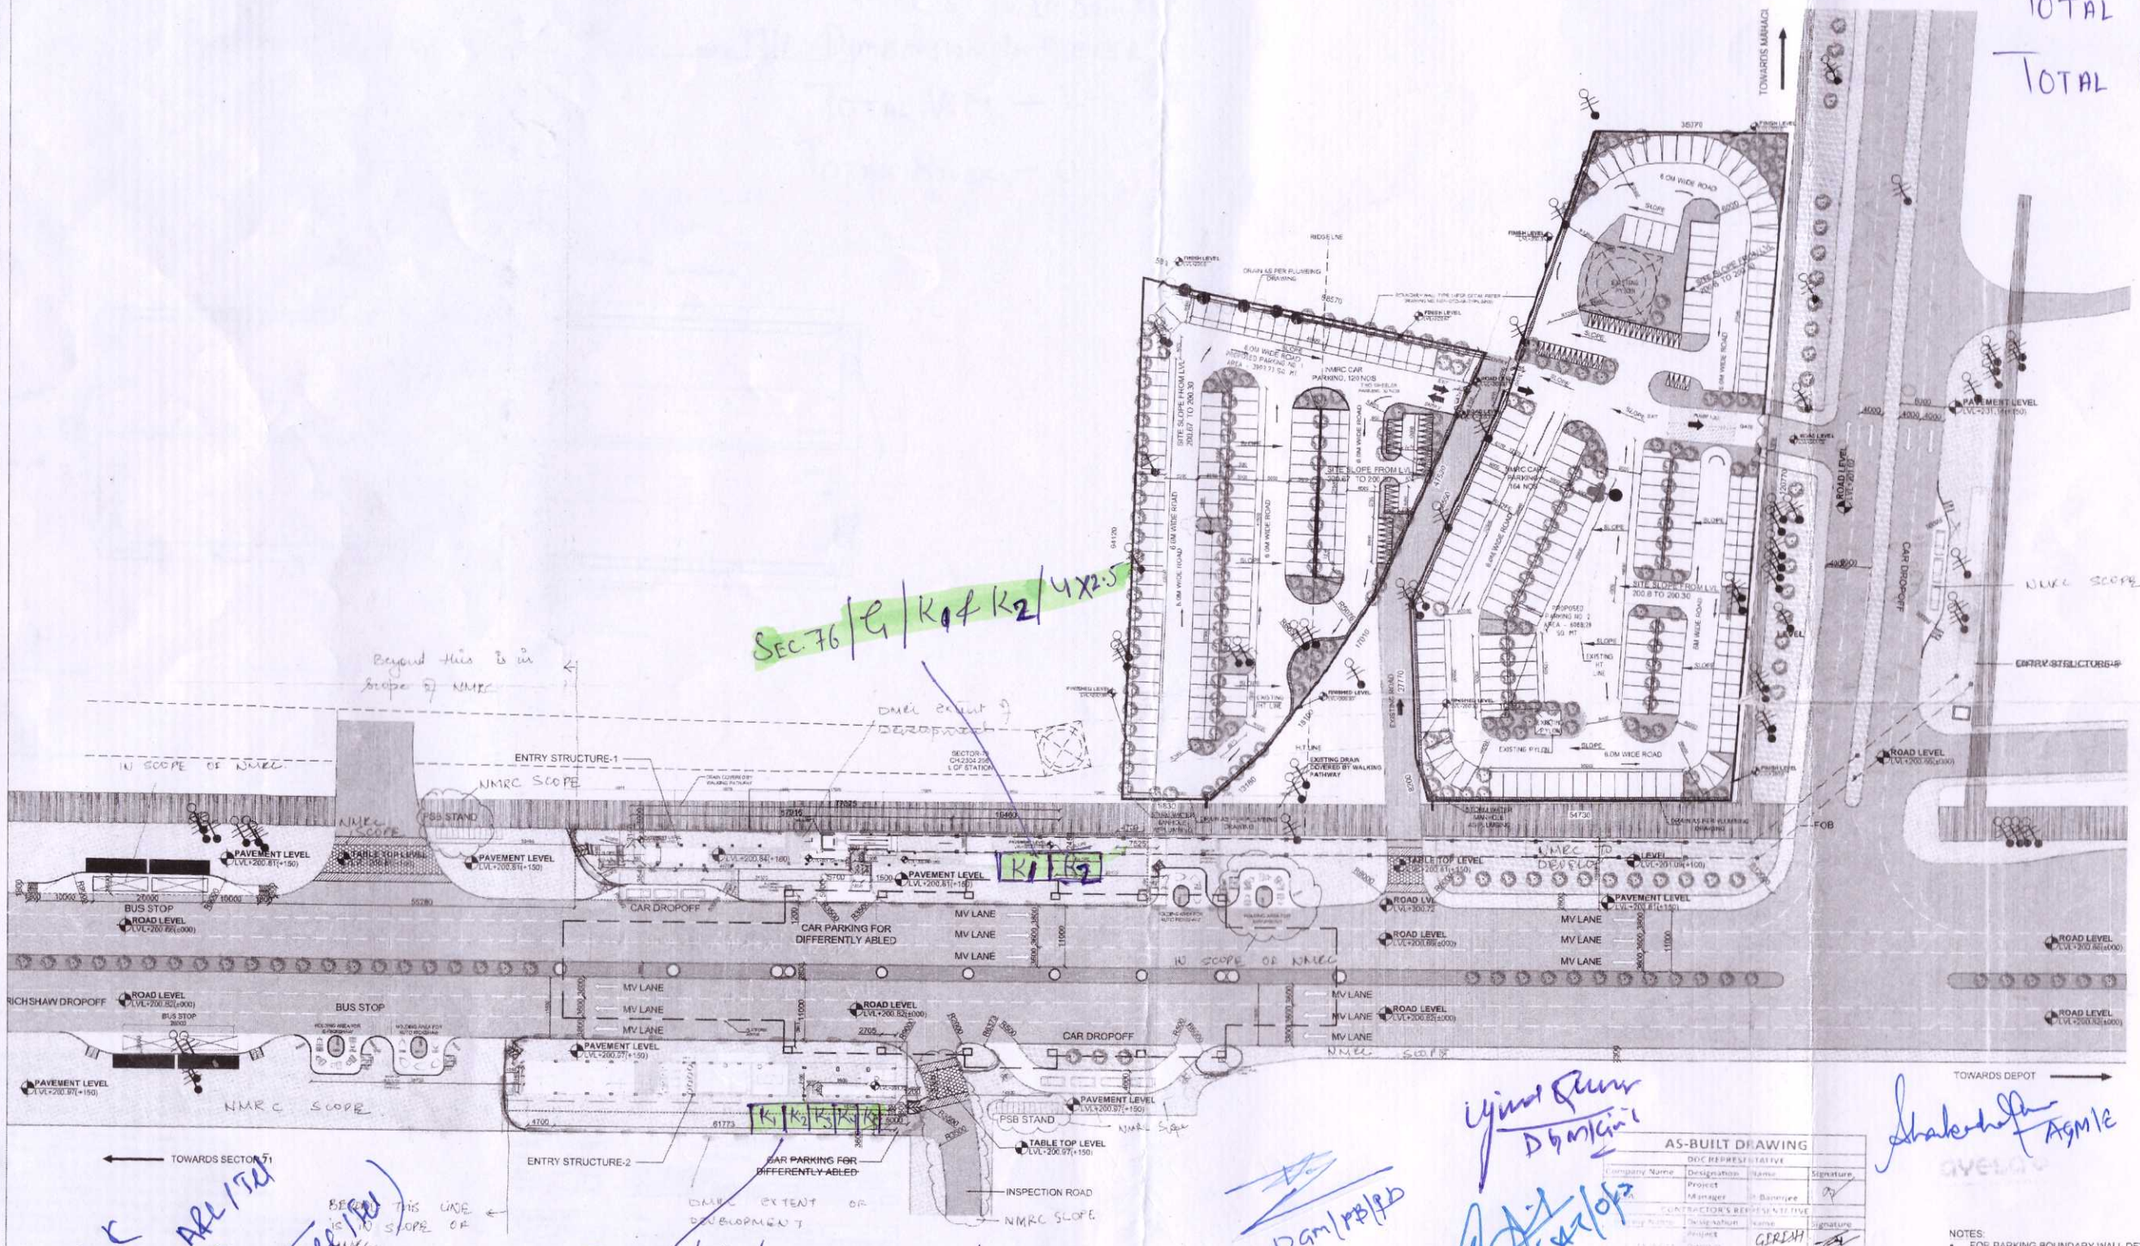

SEC. 76 / G / K1 & K2 / 4X2.5

SEC. 76 / OD / K-1 TO K-5 / 5X2

O.K
Co. rt. ARL/TEL
DGM(ARL/TEL)

DGM/PB/PD

DGM/Civil

JGM/S&T/O&T

AGM/E

LEGEND

- LIGHT COLOUR LOAD BEARING PAVER BLOCKS IN PARKING BAY
- DARK COLOUR LOAD BEARING PAVER BLOCKS IN PARKING DRIVE WAY
- PAVER BLOCKS (LIGHT)
- PAVER BLOCKS (DARK)
- ROAD
- SHRUBS
- MAINTAINED GREEN
- WILD GREEN
- CYCLE TRACK
- DROP OFF AREA (CONCRETE)
- EXITING ELECTRICAL POLES
- EXITING TREES
- TREES TO BE OUT-RELOCATED
- PROPOSED TREES
- LAND PLAN
- AREA OF EXTENT OF EXTERNAL DEVELOPMENT

AS-BUILT DRAWING

DOC REPRESENTATIVE

Company Name	Designation	Name	Signature
	Project Manager	P. Banerjee	

CONTRACTOR'S REPRESENTATIVE

Company Name	Designation	Name	Signature
	Project Director	GERISH	

NOTES:

- FOR PARKING BOUNDARY WALL DETAIL REFER SEPARATE DRAWING.NO.NGN-DTD-AR-TYPL-5200
- FOR FLOORING PATTERN NEAR ENTRY/EXIT REFER DWG.NO.-NGN-DTD-AR-TYPL-5001
- FOR EXTERNAL DEVELOPMENT TYPICAL DETAILS REFER DWG. NO. NGN-DTD-AR-TYPL-5100
- FOR STATION PARKING DETAILS REFER DWG. NO. NGN-DTD-AR-03S078-5300

GENERAL NOTES:

1. ALL DIMENSIONS ARE IN MILLIMETER UNLESS METIONED.
2. ALL DIMENSIONS ARE TO BE READ AND NOT MEASURED.
3. ANY DISCREPANCY MUST BE BROUGHT TO THE NOTICE OF THE DMRC BEFORE EXECUTION OF WORK AT SITE.
4. THIS DRAWING MUST BE READ IN CONJUNCTION WITH ALL RELEVANT ARCHITECTURAL, STRUCTURAL, PLUMBING & FIRE FIGHTING, ELECTRICAL AND TRAFFIC MANAGEMENT DRAWINGS.
5. ALL EXCAVATION OIL & LEVEL LEVELS ARE MEASURED FROM MAIN FLOOR FINISHED LEVELS.

REFERENCE DRAWINGS

REVISION	DESCRIPTION	DRAWING NO.

THIS DRAWING IS THE PROPERTY OF DELHI METRO RAIL CORPORATION LTD.

REVISIONS

REV.	DESCRIPTION	DATE	DRAWN BY	CHECKED BY

APPROVAL OF DMRC OFFICIALS

RA	Dy CA/Arch	CA	AM/Tele	Sr. DGM/Tele	ED/S&T/P-I
AM/ Elect	DGM/Elec.	CEE	AM/Sig	JGM/S&T-II	ED/S&T/P-II
AM/ AFC	Dy CSTE/AFC	MNGR/FIRE	CRE	PD/N-GN	

Certified that this document has been designed and checked in accordance with DDC Quality Assurance Plan.

Authorised Signatory for DDC. NCDD01 Project Manager

Architecture Design In-charge/ Coordinator | Structure Design In-charge/ Coordinator | E&M Design In-charge/ Coordinator

DETAIL DESIGN CONSULTANT :

ayesa Engineering. Information. Imagination.

56, Indo-Asia House, Institutional Area, sector-44
Gurgaon - 122002 (Haryana)

DELHI METRO RAIL CORPORATION LTD.
Metro Bhawan, Fire Brigade Lane, Barakhamba Road, New Delhi-110001

PROJECT: NOIDA - GREATER NOIDA CORRIDOR

STATION: SECTOR 76 (OUD) SECTOR 76

DRAWING TITLE: GROUND LEVEL PLAN

NORTH	DRAWN BY:	CHECKED BY:	VERIFIED BY:	APPROVED BY:
N	ADN	SHF	ABL	PMD
	DATE: 18.05.2017	REV: R-1	SCALE: 1:500	STATUS: AS BUILT
ORDER Nº P36-0022	DRAWING NUMBER: NGN-DTD-AR-03S078-1101		SHEET NO.	SHEET SIZE: A-1

DDC - NCD001

This drawing must not be either loaned, copied or otherwise reproduced in whole or in part or used for any purpose without the prior written permission of DMRC.